



South Elevation

SCALE 1 : 100

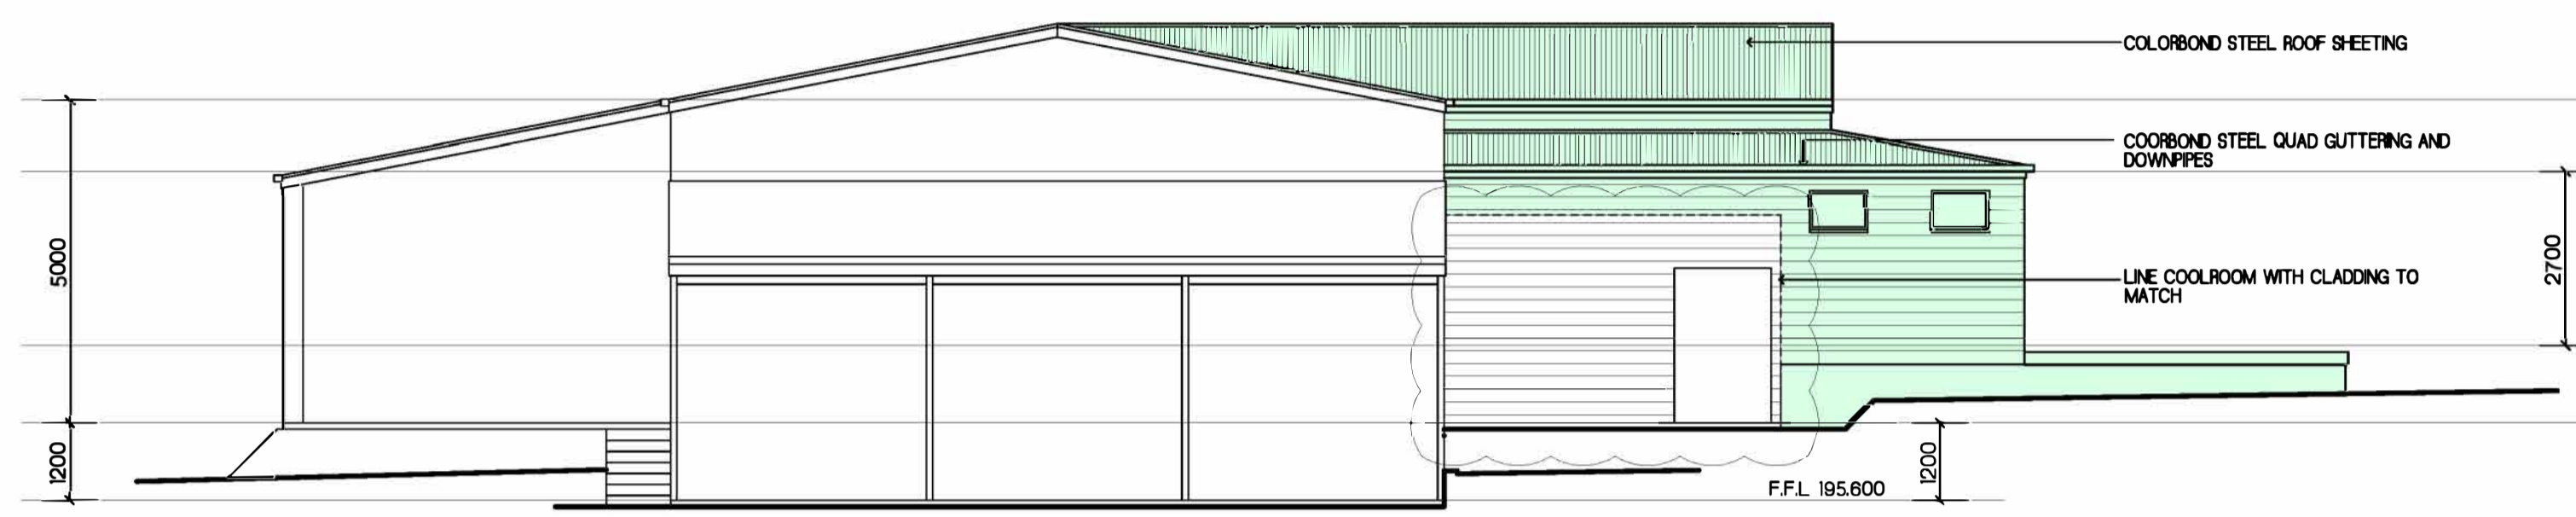


East Elevation

SCALE 1 : 100

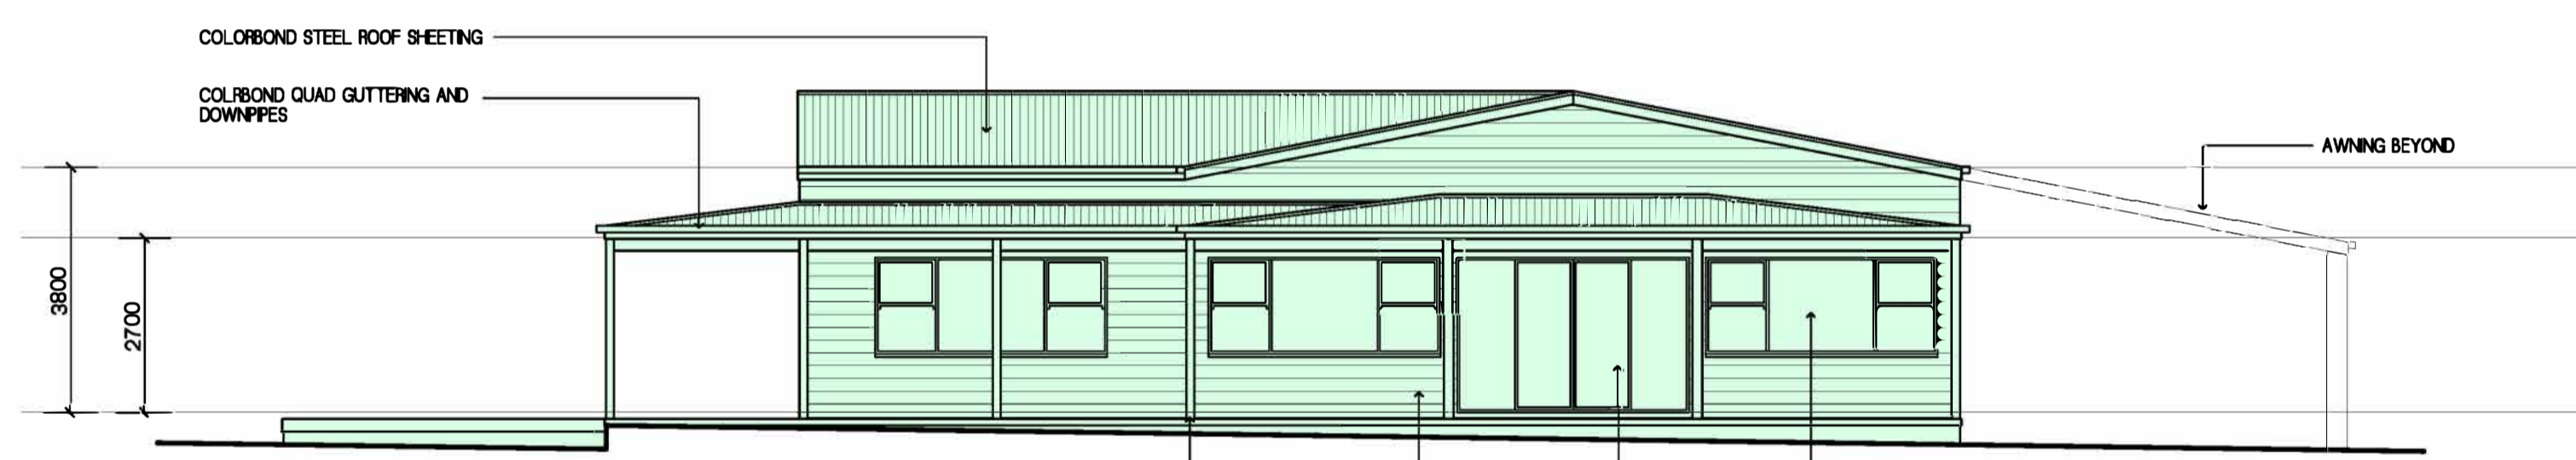

West Elevation

SCALE 1 : 100

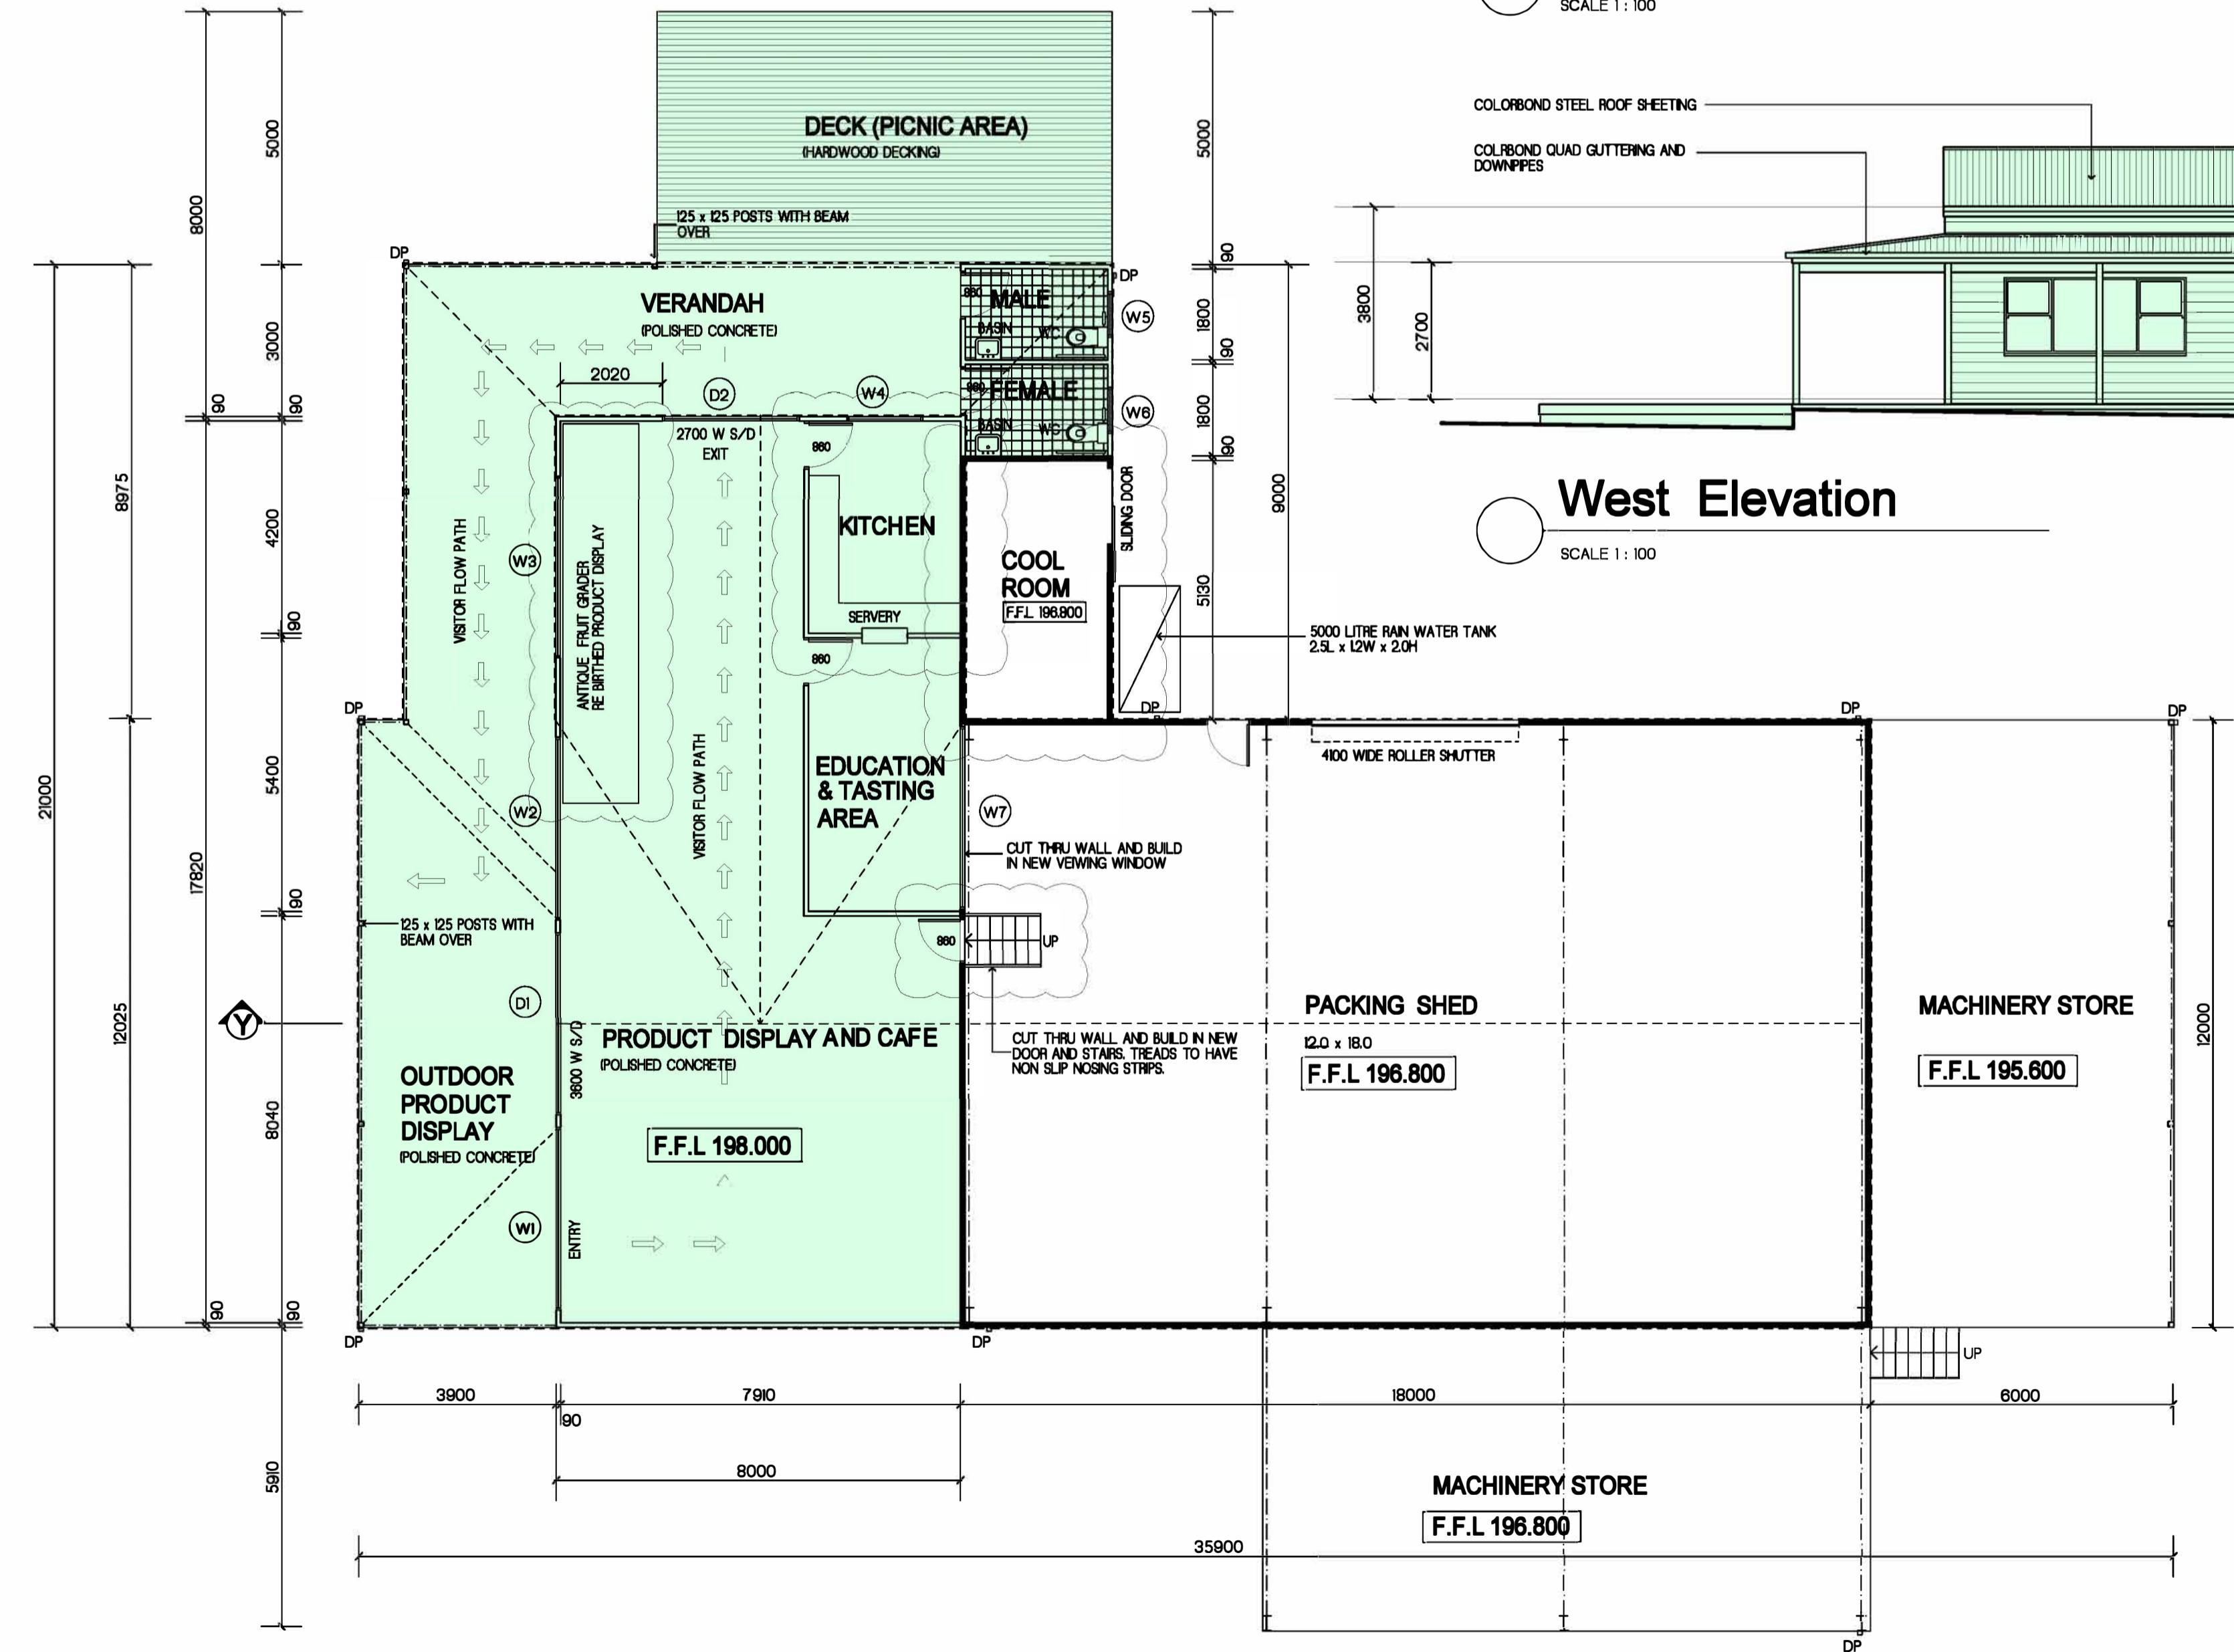

Floor Plan (Stage 2)

SCALE 1 : 100

Window / Door Schedule

No.	SIZE H x W	ORIENTATION	AREA (SQ M)
W1	1500 x 3600	WEST	5.40
W2	1500 x 3600	WEST	5.40
W3	1500 x 3600	WEST	5.40
W4	1000 x 1500	NORTH	1.50
W5	800 x 900	SOUTH	0.54
W6	800 x 900	SOUTH	0.54
W7	1500 x 3600	SOUTH	5.40
D1	2000 x 3600	WEST	7.56
D2	2000 x 2700	NORTH	5.67

No.	DATE	REVISIONS	BY
1	JULY 2015	COOL ROOM ADDED TO STAGE 1 KITCHEN LAYOUT MODIFIED ACCESS BETWEEN SHED AND PRODUCT DISPLAY ADDED VISITOR FLOW PATH ADDED POSITION OF ANTIQUE FRUIT GRADER ADDED	HN

ELECTRICAL CONSULTANT	
MECHANICAL CONSULTANT	
STRUCTURAL CONSULTANT	

Arcadian Designs
 BUILDING DESIGN
 DOMESTIC / COMMERCIAL / INDUSTRIAL
 5 GRIBBENMOUNT ROAD GALSTON NSW 2159
 PH 9653 1372 MB 0429 638 327

CLIENT **MR & MRS WADELL**

PROJECT **LOT 1, DP 836106 373
 - 375 GALSTON ROAD
 GALSTON**

TITLE **DEVELOPMENT APPLICATION**

DRAWING STATUS	REVIEWED BY	SIGNATURE	DATE
FOR INFORMATION ONLY			
FOR D.A. APPROVAL			
FOR BUILDING APPROVAL			
FOR TENDER			
FOR CONSTRUCTION			
AS BUILT DOCUMENT			

DRAWN BY	HNOLAN
SCALES	1 : 750
PLOT DATE	OCTOBER 2014

JOB No. **2014103**
 DRAWG/REV No. **4 OF 4 / 02**

NOTE:
 CONTRACTOR TO CHECK AND VERIFY ALL DIMENSIONS ON SITE BEFORE COMMENCEMENT OF WORK. FIGURED DIMENSIONS TO TAKE PREFERENCE TO SCALING